




Description **Grand Central Office for Rent**

As Built Floorplan

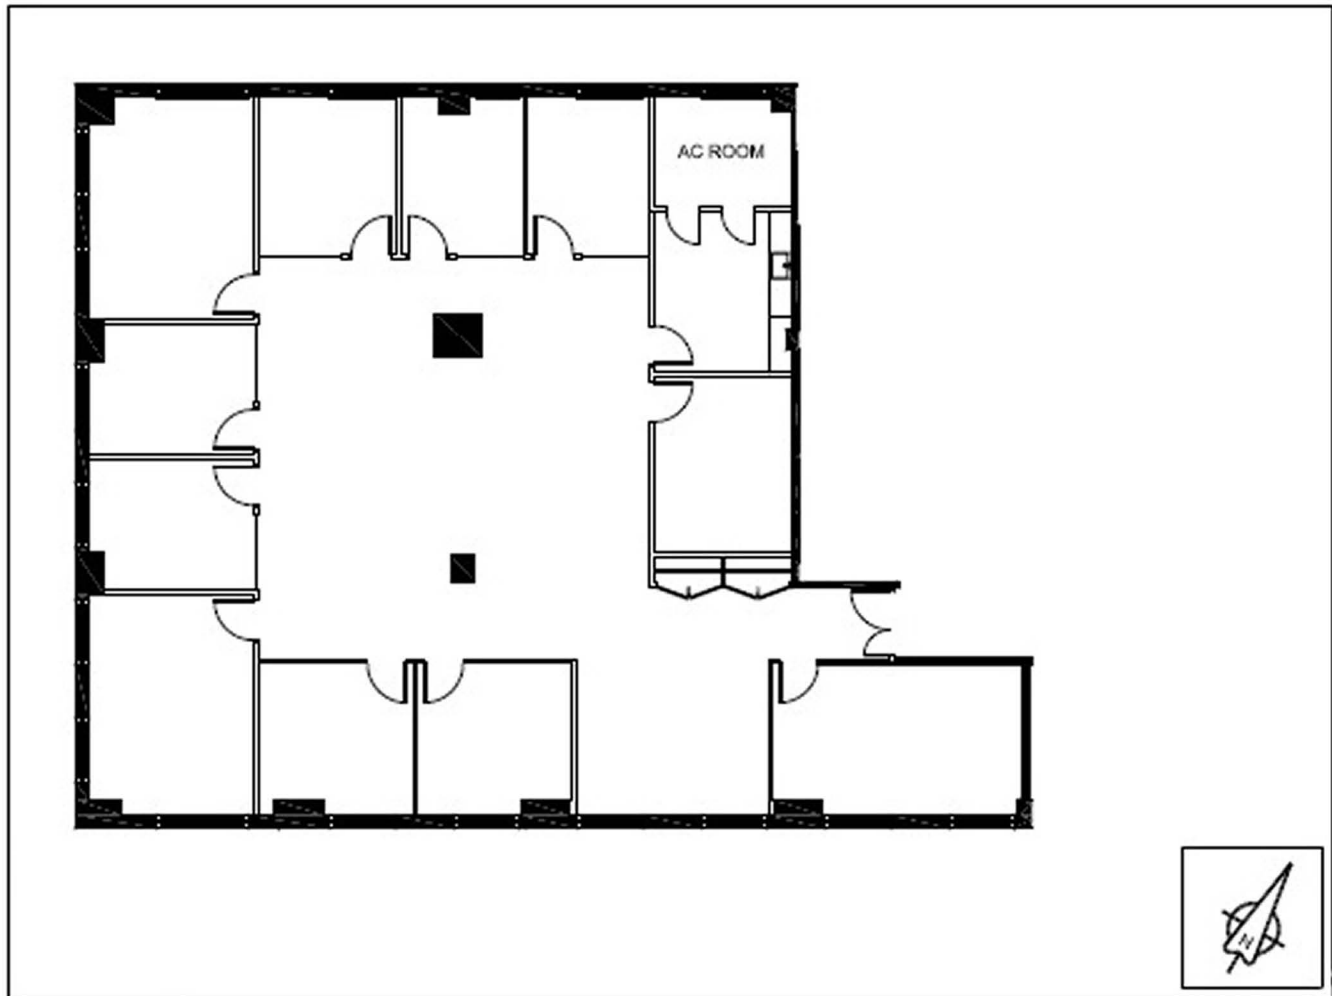

For Further Information, Please Contact

Todd Abrams
Prime Manhattan Realty
646-485-5886 - direct
212-729-6559 - cell
tabrams@pmrny.com