


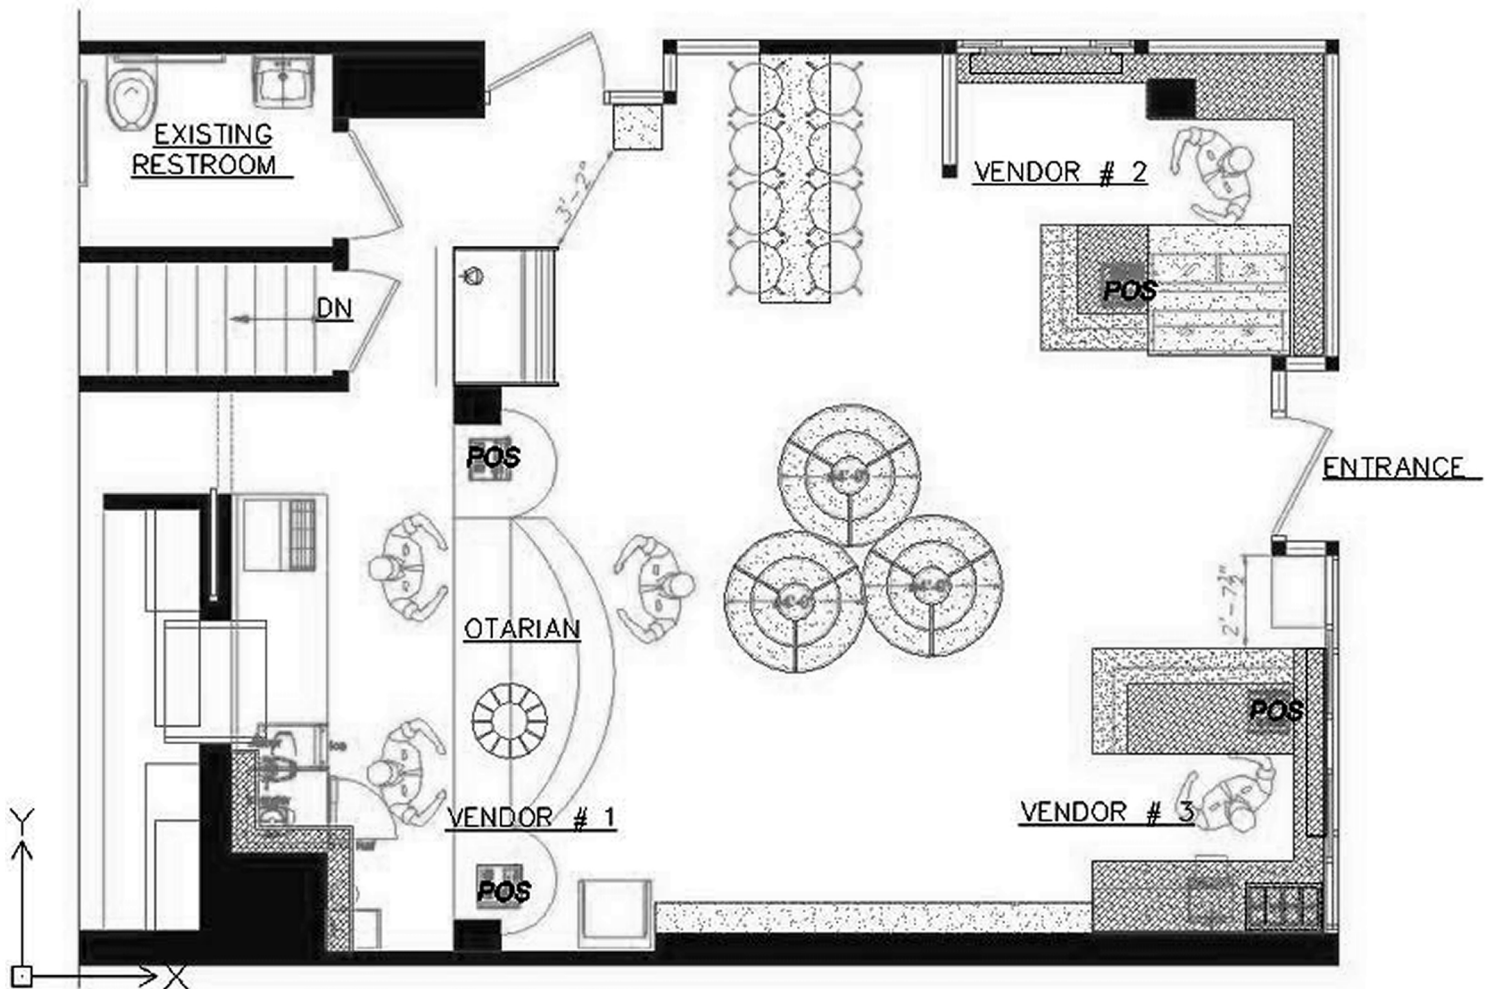

Description *Columbus Circle Restaurant Floor Plan*

As Built Floorplan



For Further Information, Please Contact

Alexander Robles

Managing Director

Prime Manhattan Realty

646-485-5888 - direct

718-909-9941 - cell

arobles@primemanhattan.com