




PRIME MANHATTAN REALTY

Commercial Real Estate Experts

Knowledgeable Professional
Real Estate Services
Since 1994

Description **Plaza District Sublet Floor Plan**

As Built Floorplan

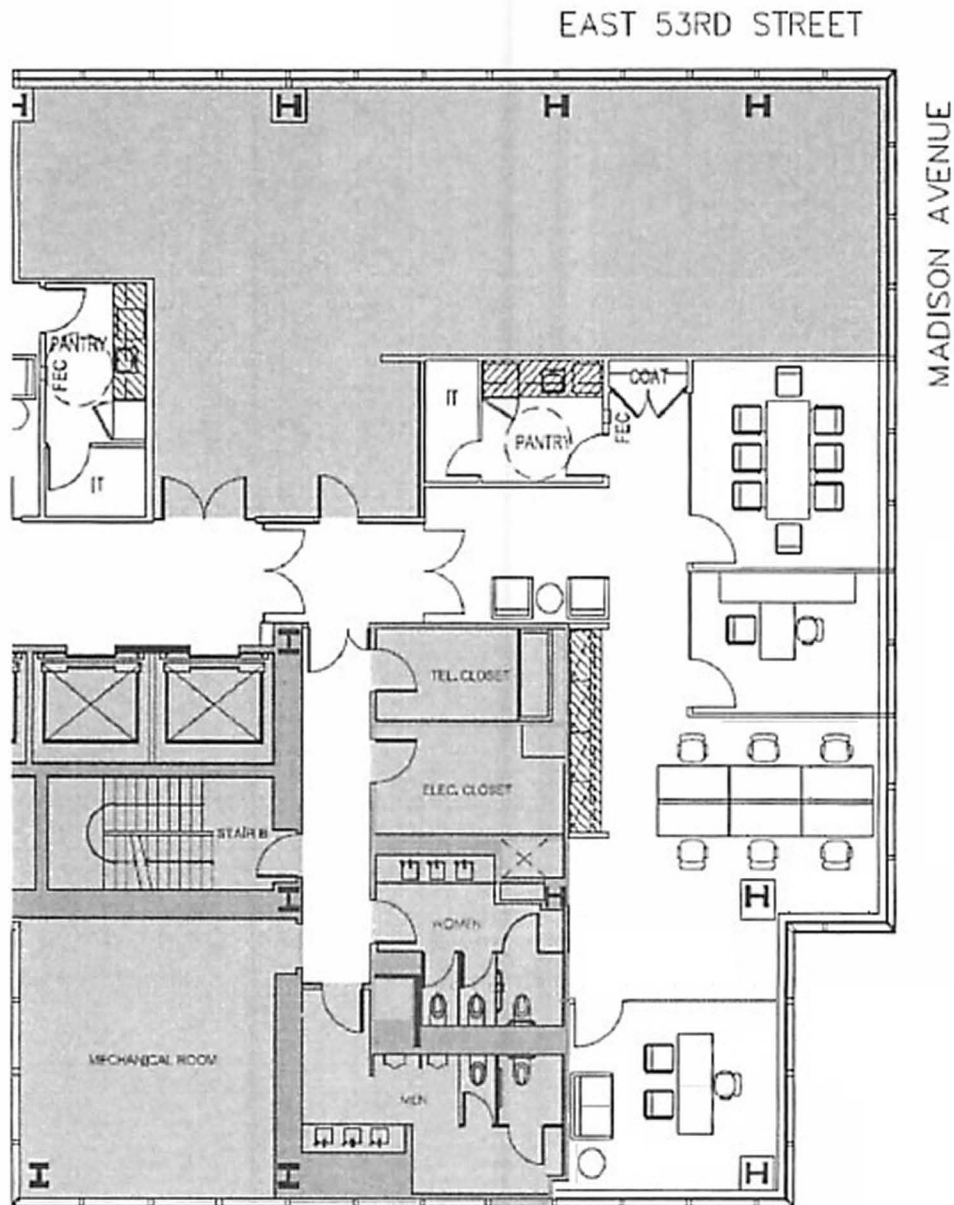

For Further Information, Please Contact

Scott Bennett
Prime Manhattan Realty
212-244-2784 - direct
646-296-0026 - cell
sbennett@pmrny.com

Todd Abrams
Prime Manhattan Realty
646-485-5886 - direct
212-729-6559 - cell
tabrams@pmrny.com