




Description *Upper East Side Dental Office for Rent*

As Built Floorplan

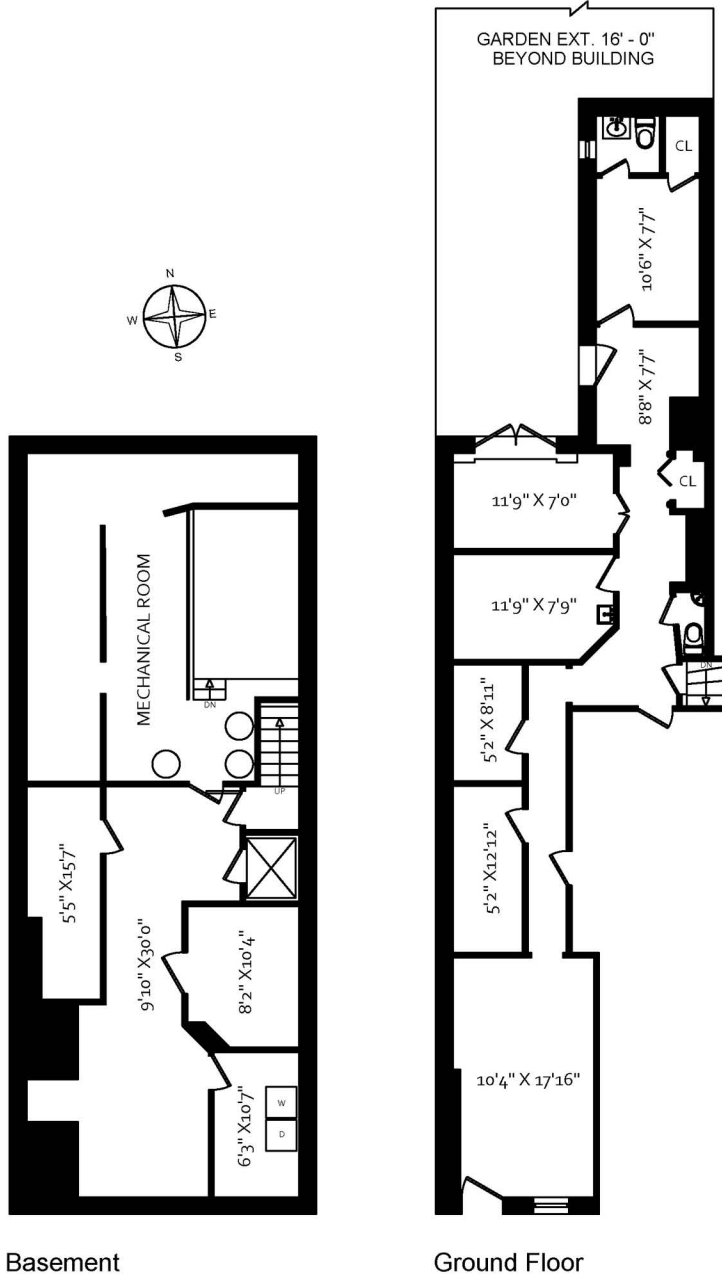

For Further Information, Please Contact

Stanley J. Piesh
Prime Manhattan Realty
212-594-7354 - direct
917-282-8590 - cell
spiesh@pmrny.com